

NOTE: ALL FLOOR SLAB DETAILING IS FOR THE APPOINTED STRUCTURAL ENGINEER.
ALL INTERNAL GLAZING IS TO USE THE SHEERLINE GATEWAY SYSTEM.
EXTERNAL GLAZING IS TO USE THE SHEERLINE VISTA WALL SYSTEM,
UNLESS OTHERWISE INDICATED.

GENERAL NOTES

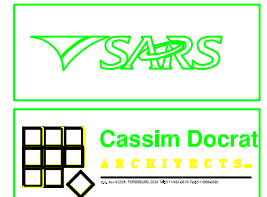
THIS DRAWING IS NOT TO BE SCALED.
FIGURES DIMENSIONS TO BE USED AT ALL TIMES.

CONTRACTOR IS RESPONSIBLE FOR CORRECT SETTING OUT OF THE BUILDING,
ALL ELEVATIONS, AND SPACIAL WALLS WITH PARTICULAR REFERENCE TO BUILDING
LINE, CORNER, ETC.

CONTRACTOR TO VERIFY ALL LEVELS, HEIGHTS AND DIMENSIONS ON SITE
AND TO CHECK SAME AGAINST THE DRAWING BEFORE PUTTING ANY WORK
IN PLACE.

ALL CONTRACTORS TO CHECK SETTING DRAWING ON THIS DRAWING FOR
CONFORMANCE WITH ELEVATIONS AND SPACIAL WALLS. CONTRACTOR WITH PARTICULAR
REFERENCE TO SPECIAL REQUIREMENTS INDICATED BY LOCAL AND OR ON
SITE CONDITIONS AND REPORT ANY CORRECTION TO THE ARCHITECT.

ANY OTHER DISCREPANCIES OR OMISSIONS TO BE REPORTED TO THE
ARCHITECT IMMEDIATELY.

[illegible][illegible][illegible]

PROJECT
A.C.S.A.
JOHANNESBURG INTERNATIONAL
AIRPORT, PROPOSED NORTHWING
OFFICES FOR S.A.R.S.

DRAWING PLAN OF DRY-WALLING

SCALE 1:100	DATE 09/01/03	DRAWN BHARATRIKAM	REVISION 5
PROJECT No. 009		DRAWING No. 202	